


'PRE EXISTING'
proposed

As approved (with 1.7m obscure condition)

As built

Now

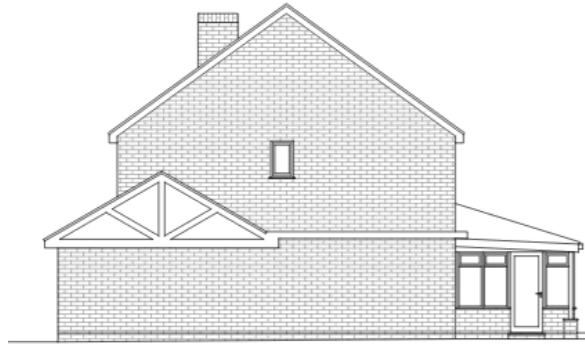

EXISTING SIDE ELEVATION



PROPOSED SIDE ELEVATION



AS-BUILT SIDE ELEVATION



AS-BUILT SIDE ELEVATION




EXISTING SIDE ELEVATION



PROPOSED SIDE ELEVATION



AS-BUILT SIDE ELEVATION

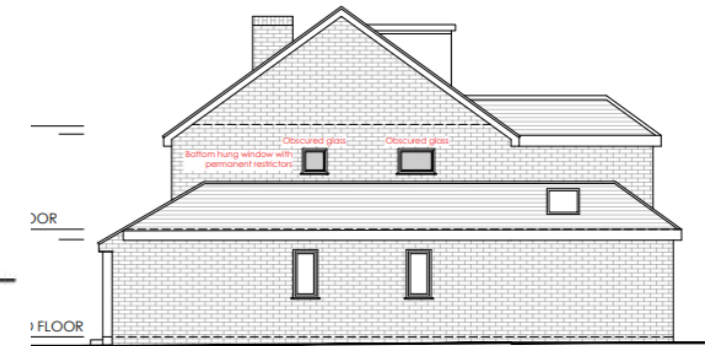

AS-BUILT SIDE ELEVATION